



MATCHLINE SHEET 3

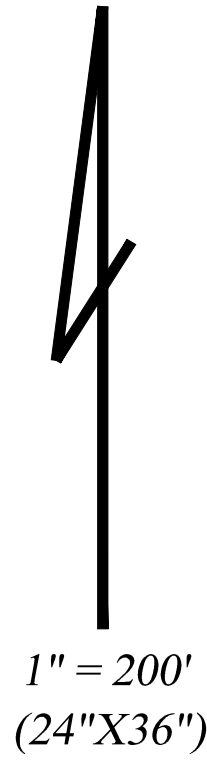

MATCHLINE SHEET 1

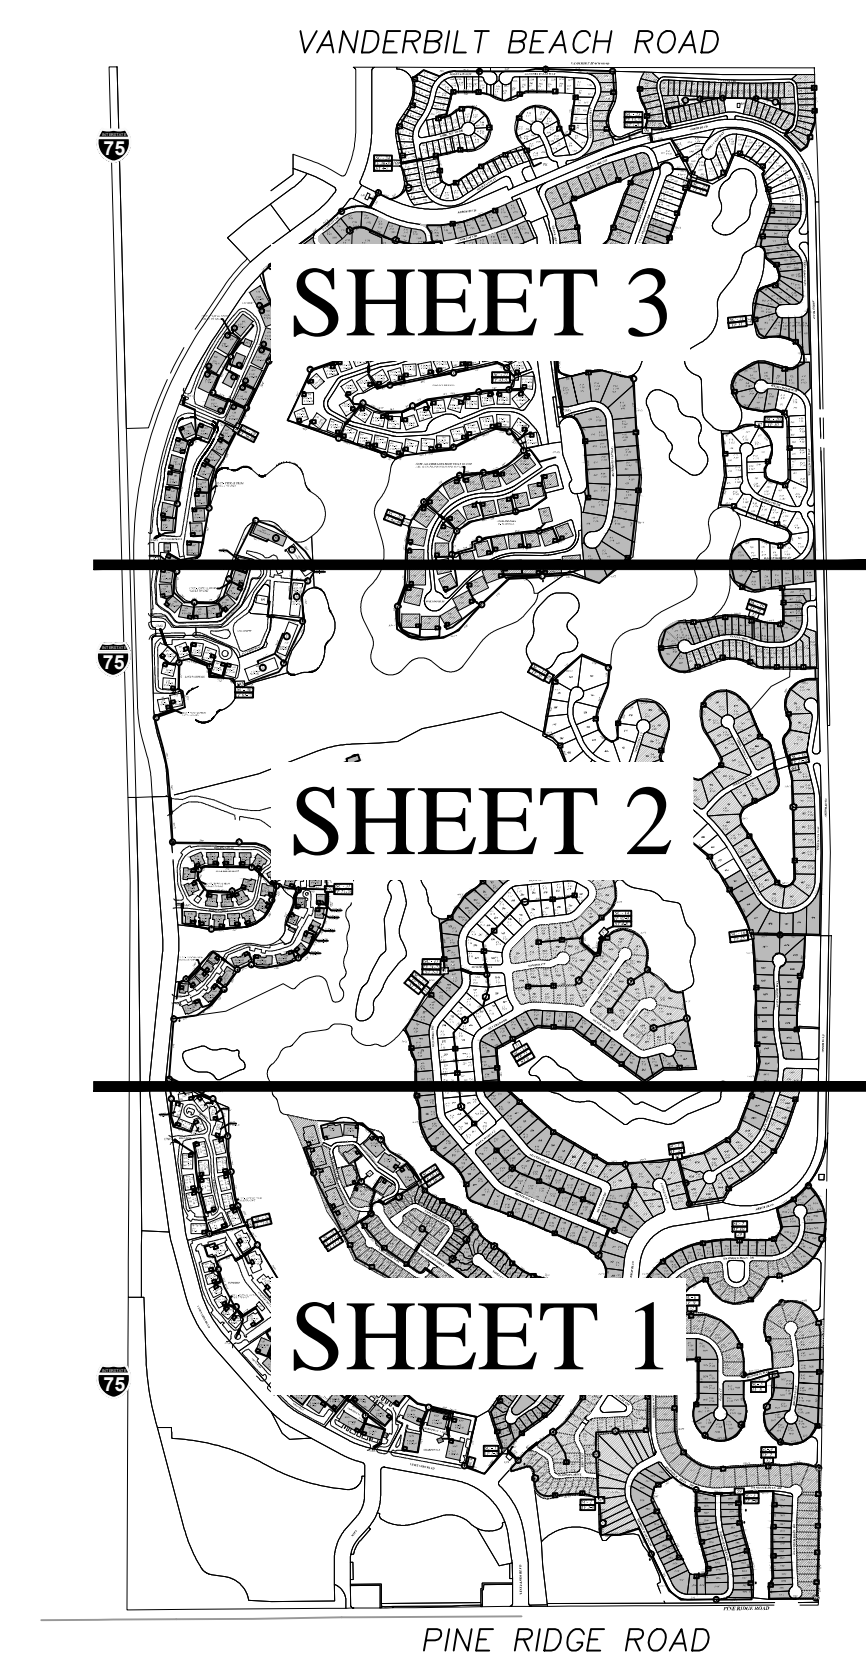

PROJECT NAME:
**VINEYARDS
 GOLF & COUNTRY CLUB**

- 4 - RESIDENTIAL \ BUILDING FIBER COUNT
- 6 - RESIDENTIAL \ BUILDING FIBER COUNT
- 8 - RESIDENTIAL \ BUILDING FIBER COUNT
- 12 - RESIDENTIAL \ BUILDING FIBER COUNT
- PH - POOL HOUSE
- UMG - UNMANNED GUARDHOUSE

- LEGEND
- 5999 - HOUSE ADDRESS
 - SC-3 - SPLITTER CABINET W/D NUMBER
 - NOTE: TOTAL SHOWN IN TOTAL UNIT COUNT AT HUB SITE
 - 59 - SPLITTER CABINET W/UNIT COUNT
 - V - VAULT BOX
 - DISTRIBUTION LINE W \ LENGTH

PLAN VIEW

NUVU
 28901 TRAILS EDGE BLVD BLDG. 203
 BONITA SPRING, FLORIDA 34134
 PHONE: 239-284-9038 - FAX: 239-992-6812

SHEET 2
 OF 3