


1" = 200'  
(24"X36")



NOTE: ALL FIBER LINES FROM VAULT TO UNIT ARE 12 CT UNLESS OTHERWISE NOTED

MATCHLINE SHEET 2

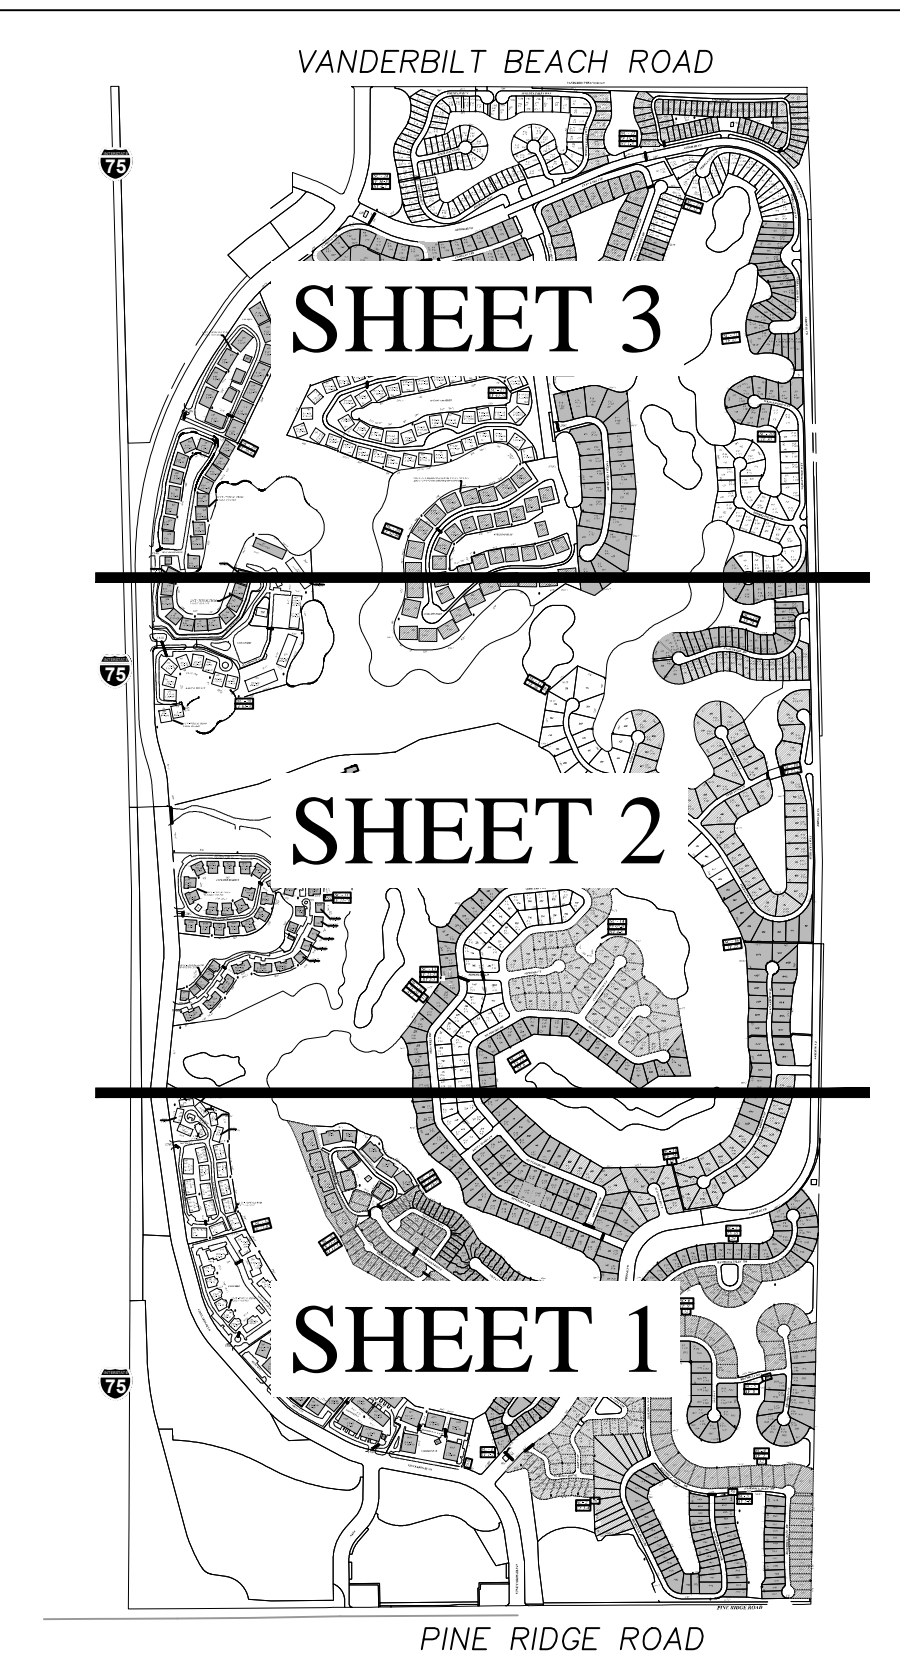

PROJECT NAME: **VINEYARDS GOLF & COUNTRY CLUB**

- LEGEND**
- 5999 - HOUSE ADDRESS
  - SC-3 - SPLITTER CABINET W/D NUMBER
  - NOTE: TOTAL SHOWN IN TOTAL UNIT COUNT AT HUB SITE
  - 4 - RESIDENTIAL \ BUILDING FIBER COUNT
  - 59 - SPLITTER CABINET W/UNIT COUNT
  - NOTE: TOTAL SHOWN IN TOTAL UNIT COUNT AT HUB SITE
  - 8 - UNMANNED GUARDHOUSE
  - V - VAULT BOX
  - PH - POOL HOUSE
  - UMG - UNMANNED GUARDHOUSE
  - DISTRIBUTION LINE W \ LENGTH

### PLAN VIEW

**NUVU**  
28901 TRAILS EDGE BLVD BLDG. 203  
BONITA SPRING, FLORIDA 34134  
PHONE: 239-284-9038 - FAX: 239-992-6812